


PLAN VIEW

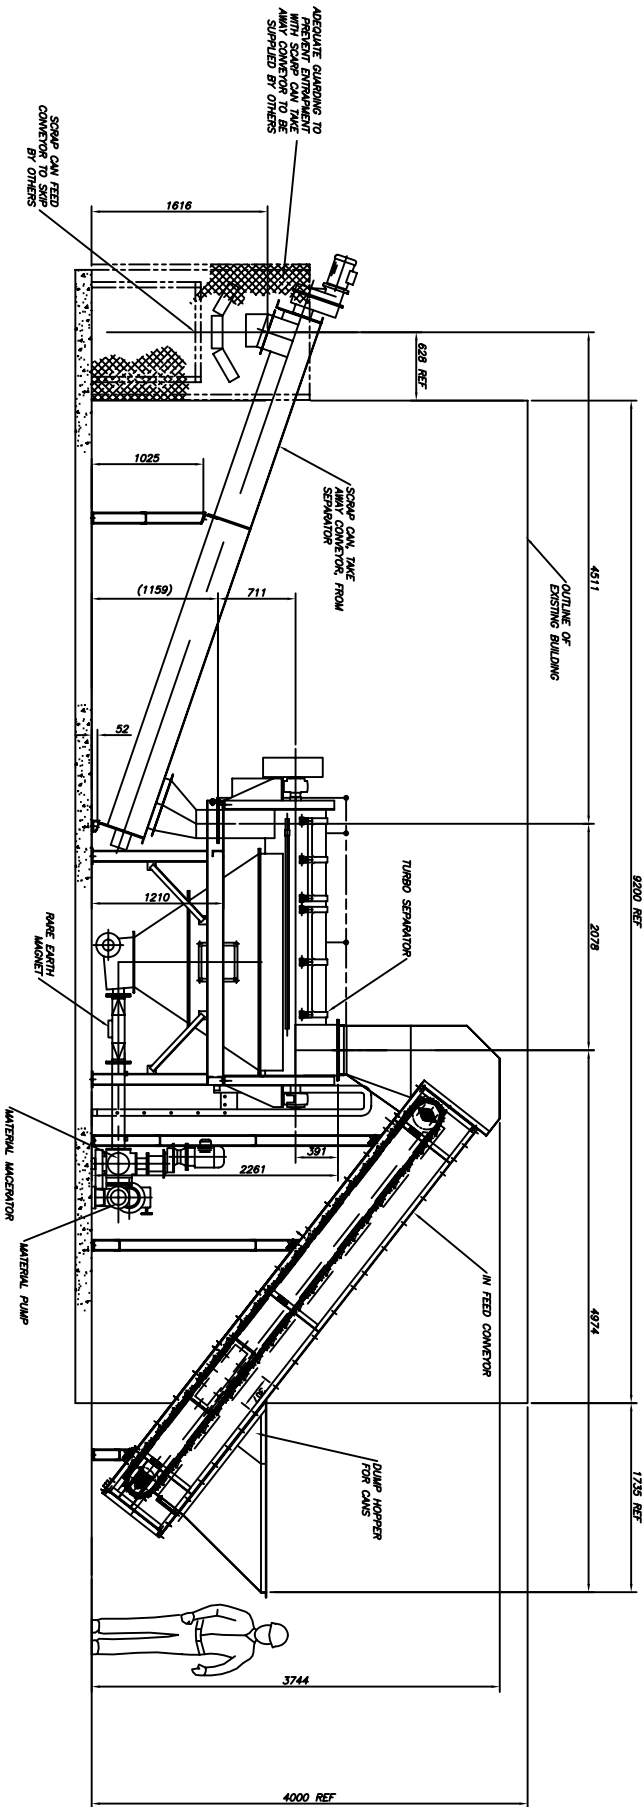

ELEVATION

SIGNED: _____
 DATE: _____
 APPROVED AS SUBMITTED
 APPROVED AS NOTED
 UPDATE & RESUBMIT

4	DRG. ADDED TO "AS BUILT" R/L 23.11.04
3	PUMP ARRANGEMENT MODIFIED. S/M 02/07/04
2	DRAWING UPDATED WITH ACTUAL CONVEYORS 08/07/04 R/W ORIGINAL
1	ORIGINAL

NOTE: THIS DRAWING IS COPYRIGHT
 AND MUST NOT BE USED WITHOUT
 THE WRITTEN PERMISSION OF ATRITOR L&D
 UNLESS INDICATED OTHERWISE. IF IN DOUBT ASK
 DO NOT SCALE DRAWING

TITLE: TURBO SEPARATOR
 PROCESS PLANT
 LAYOUT DRAWING

CLIENT: _____

ATRITOR Ltd
 COVENTRY U.K.

DATE: 25-05-04
 DRAWN: SJM
 SCALE: 1:25
 PROJ. NO: T0408504